

**GENERAL NOTES**  
 1. DO NOT SCALE FROM THE DRAWINGS.  
 2. ALL DIMENSIONS ARE IN METERS UNLESS OTHERWISE NOTED.


(17th Floor)

AS BUILT

Rev	Date	Description	Drawn	Checked	Appr
0	22-01-02	Rev 0:70 First Issue	Asst/Enr		

Project:  
 3B + G + 5P + 3S + 30 FLOORS + H.C  
 COMMERCIAL / OFFICES TOWER  
 ON PLOT NO. A-002-037,  
 TECOM, DUBAI

Client:  
 MR. HAMAD SUHAIL O. AL KHAILI


Contractor:  
 National Engineering Bureau  
 100, Al Khaili Street, P.O. Box 197, Dubai, U.A.E.

Contractor:  
 Transemirates Co. L.L.C.  
 Tel: 04-2023844 Fax: 04-2668077 P.O. Box 3253 DUB  
 Email: tcc@tcc-uae.com

Drawing Title:  
 17th FLOOR PLAN  
 (SERVICE FLOOR)

Original Scale	Drawn	Checked	Approved	She
1:200	Date: 22-01-02	Date:	Date:	

Drawing Number: A1-20

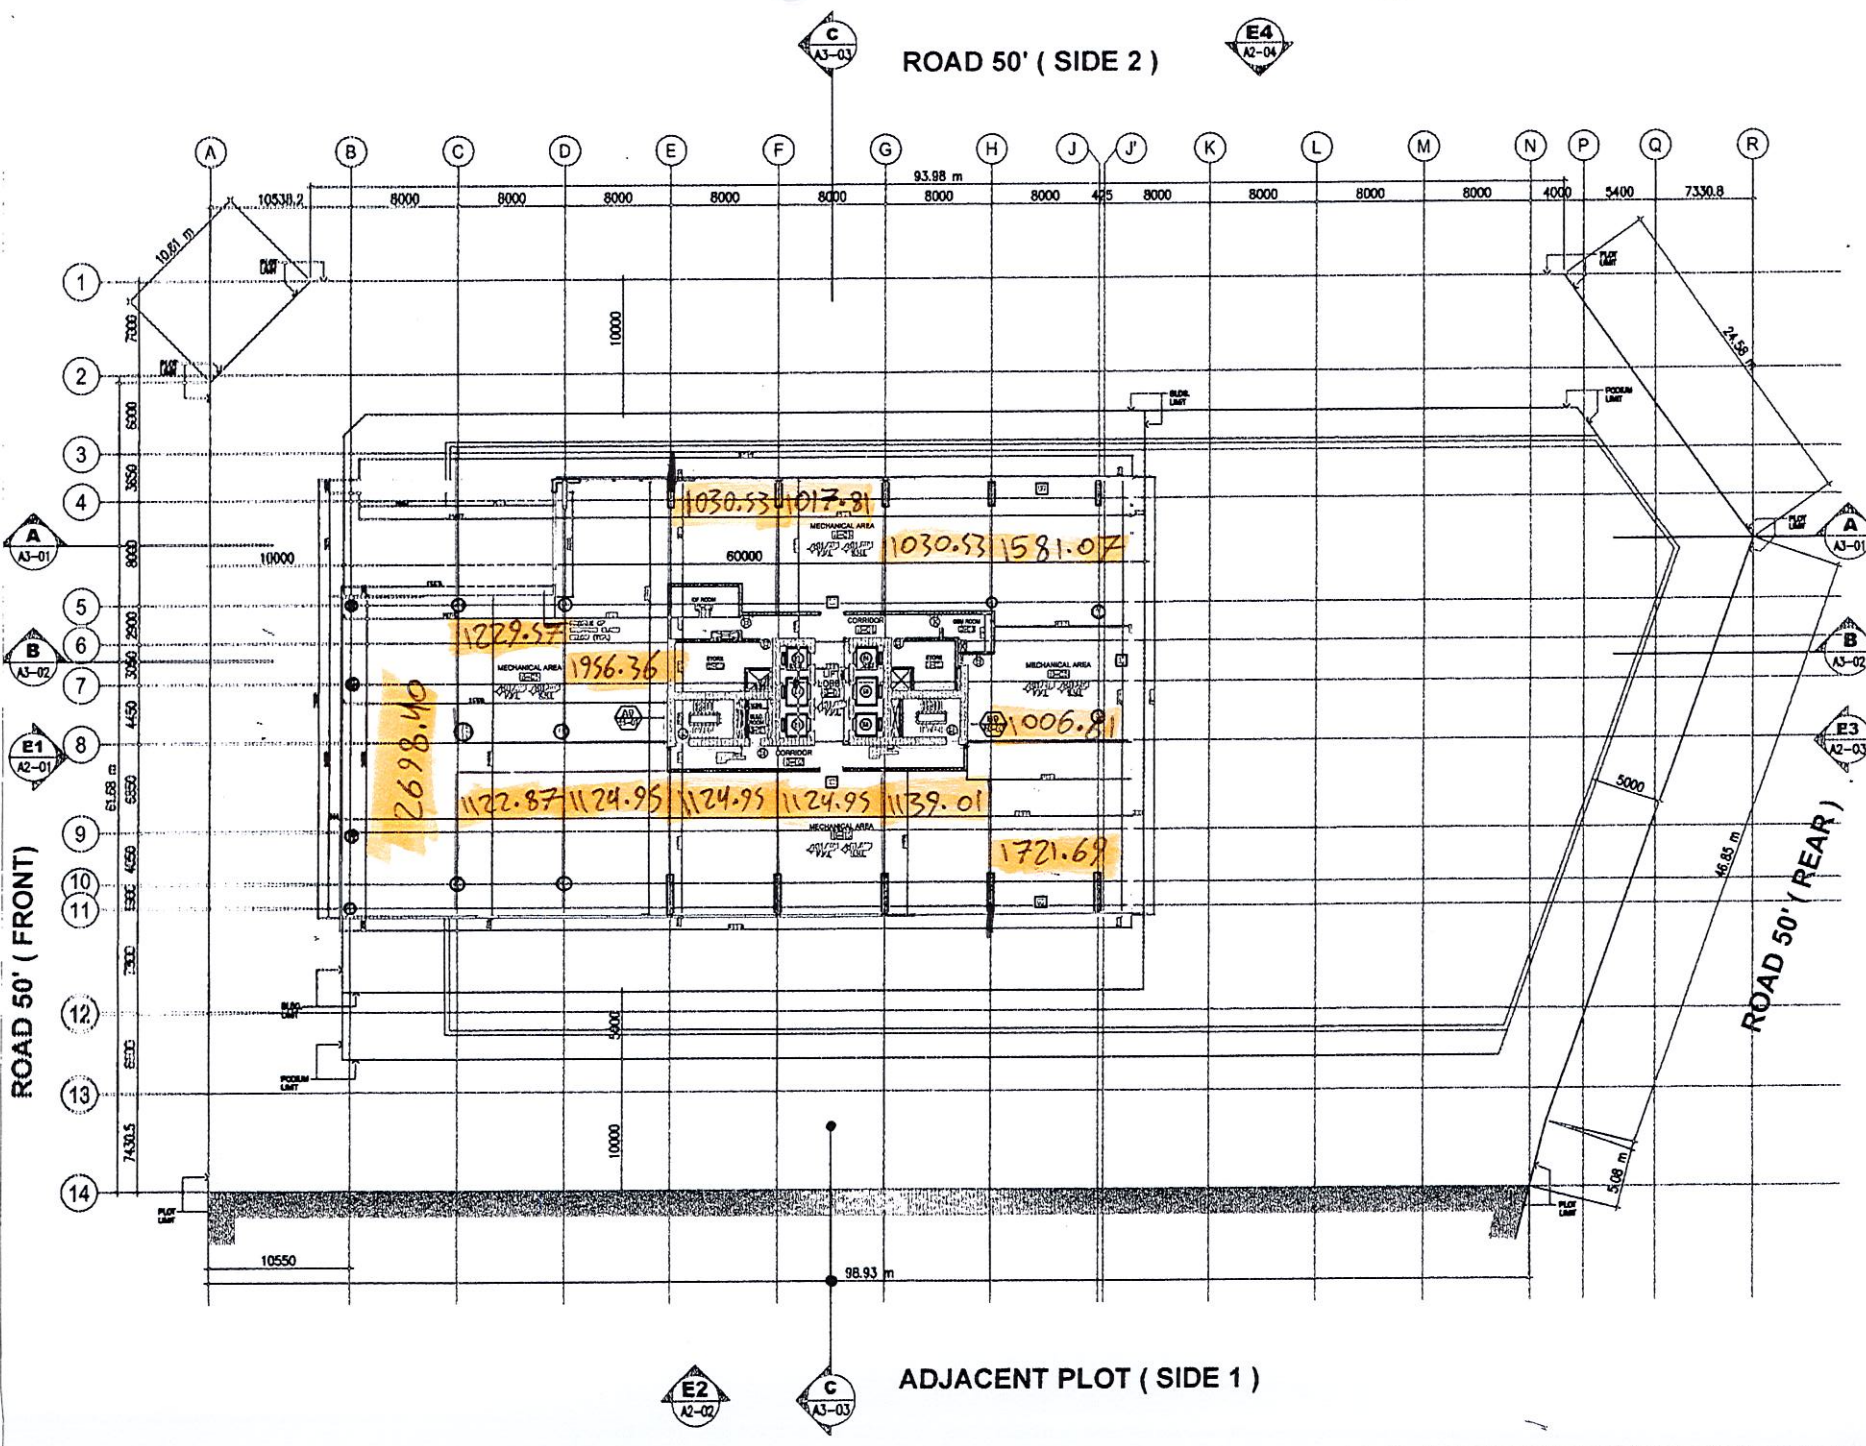

ROAD 50' (SIDE 2)

ROAD 50' (FRONT)

ROAD 50' (REAR)

ADJACENT PLOT (SIDE 1)